

**Map Legend**

**Culinary Line Size**

- Culinary Line Size
- Fire Hydrant
- Gate Valve


**Culinary Main Size**

- 20 Inch Main
- 18 Inch Main
- 16 Inch Main
- 14 Inch Main
- 12 Inch Main
- 10 Inch Main
- 8 Inch Main
- 6 Inch Main
- 4 Inch Main
- 3 Inch Main
- 2 Inch Main

- Railroad
- City Limits
- Golf
- Coal Creek
- Roads
- PUD

Map Printed: Feb. 5, 2021

**CEDAR CITY CORPORATION**  
**CULINARY WATER MAIN ASBUILT MAP**

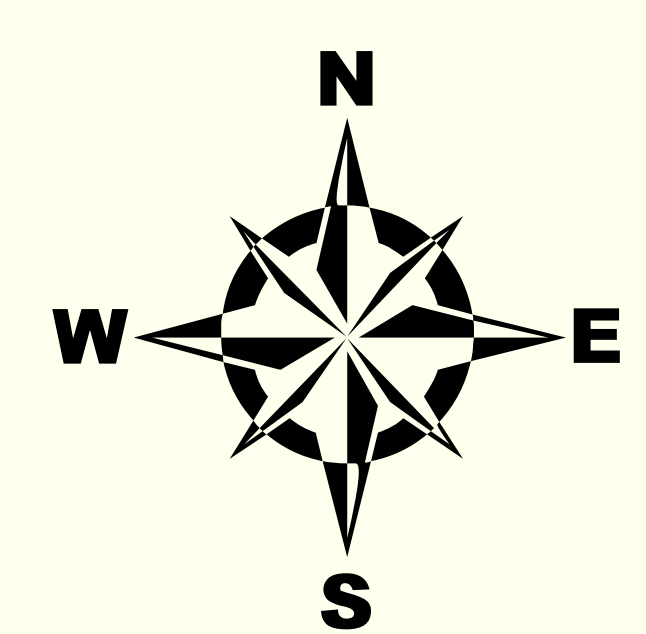

Scale: 1"=800'



**CEDAR CITY CORP.**  
 10 North Main  
 Cedar City, Utah 84720