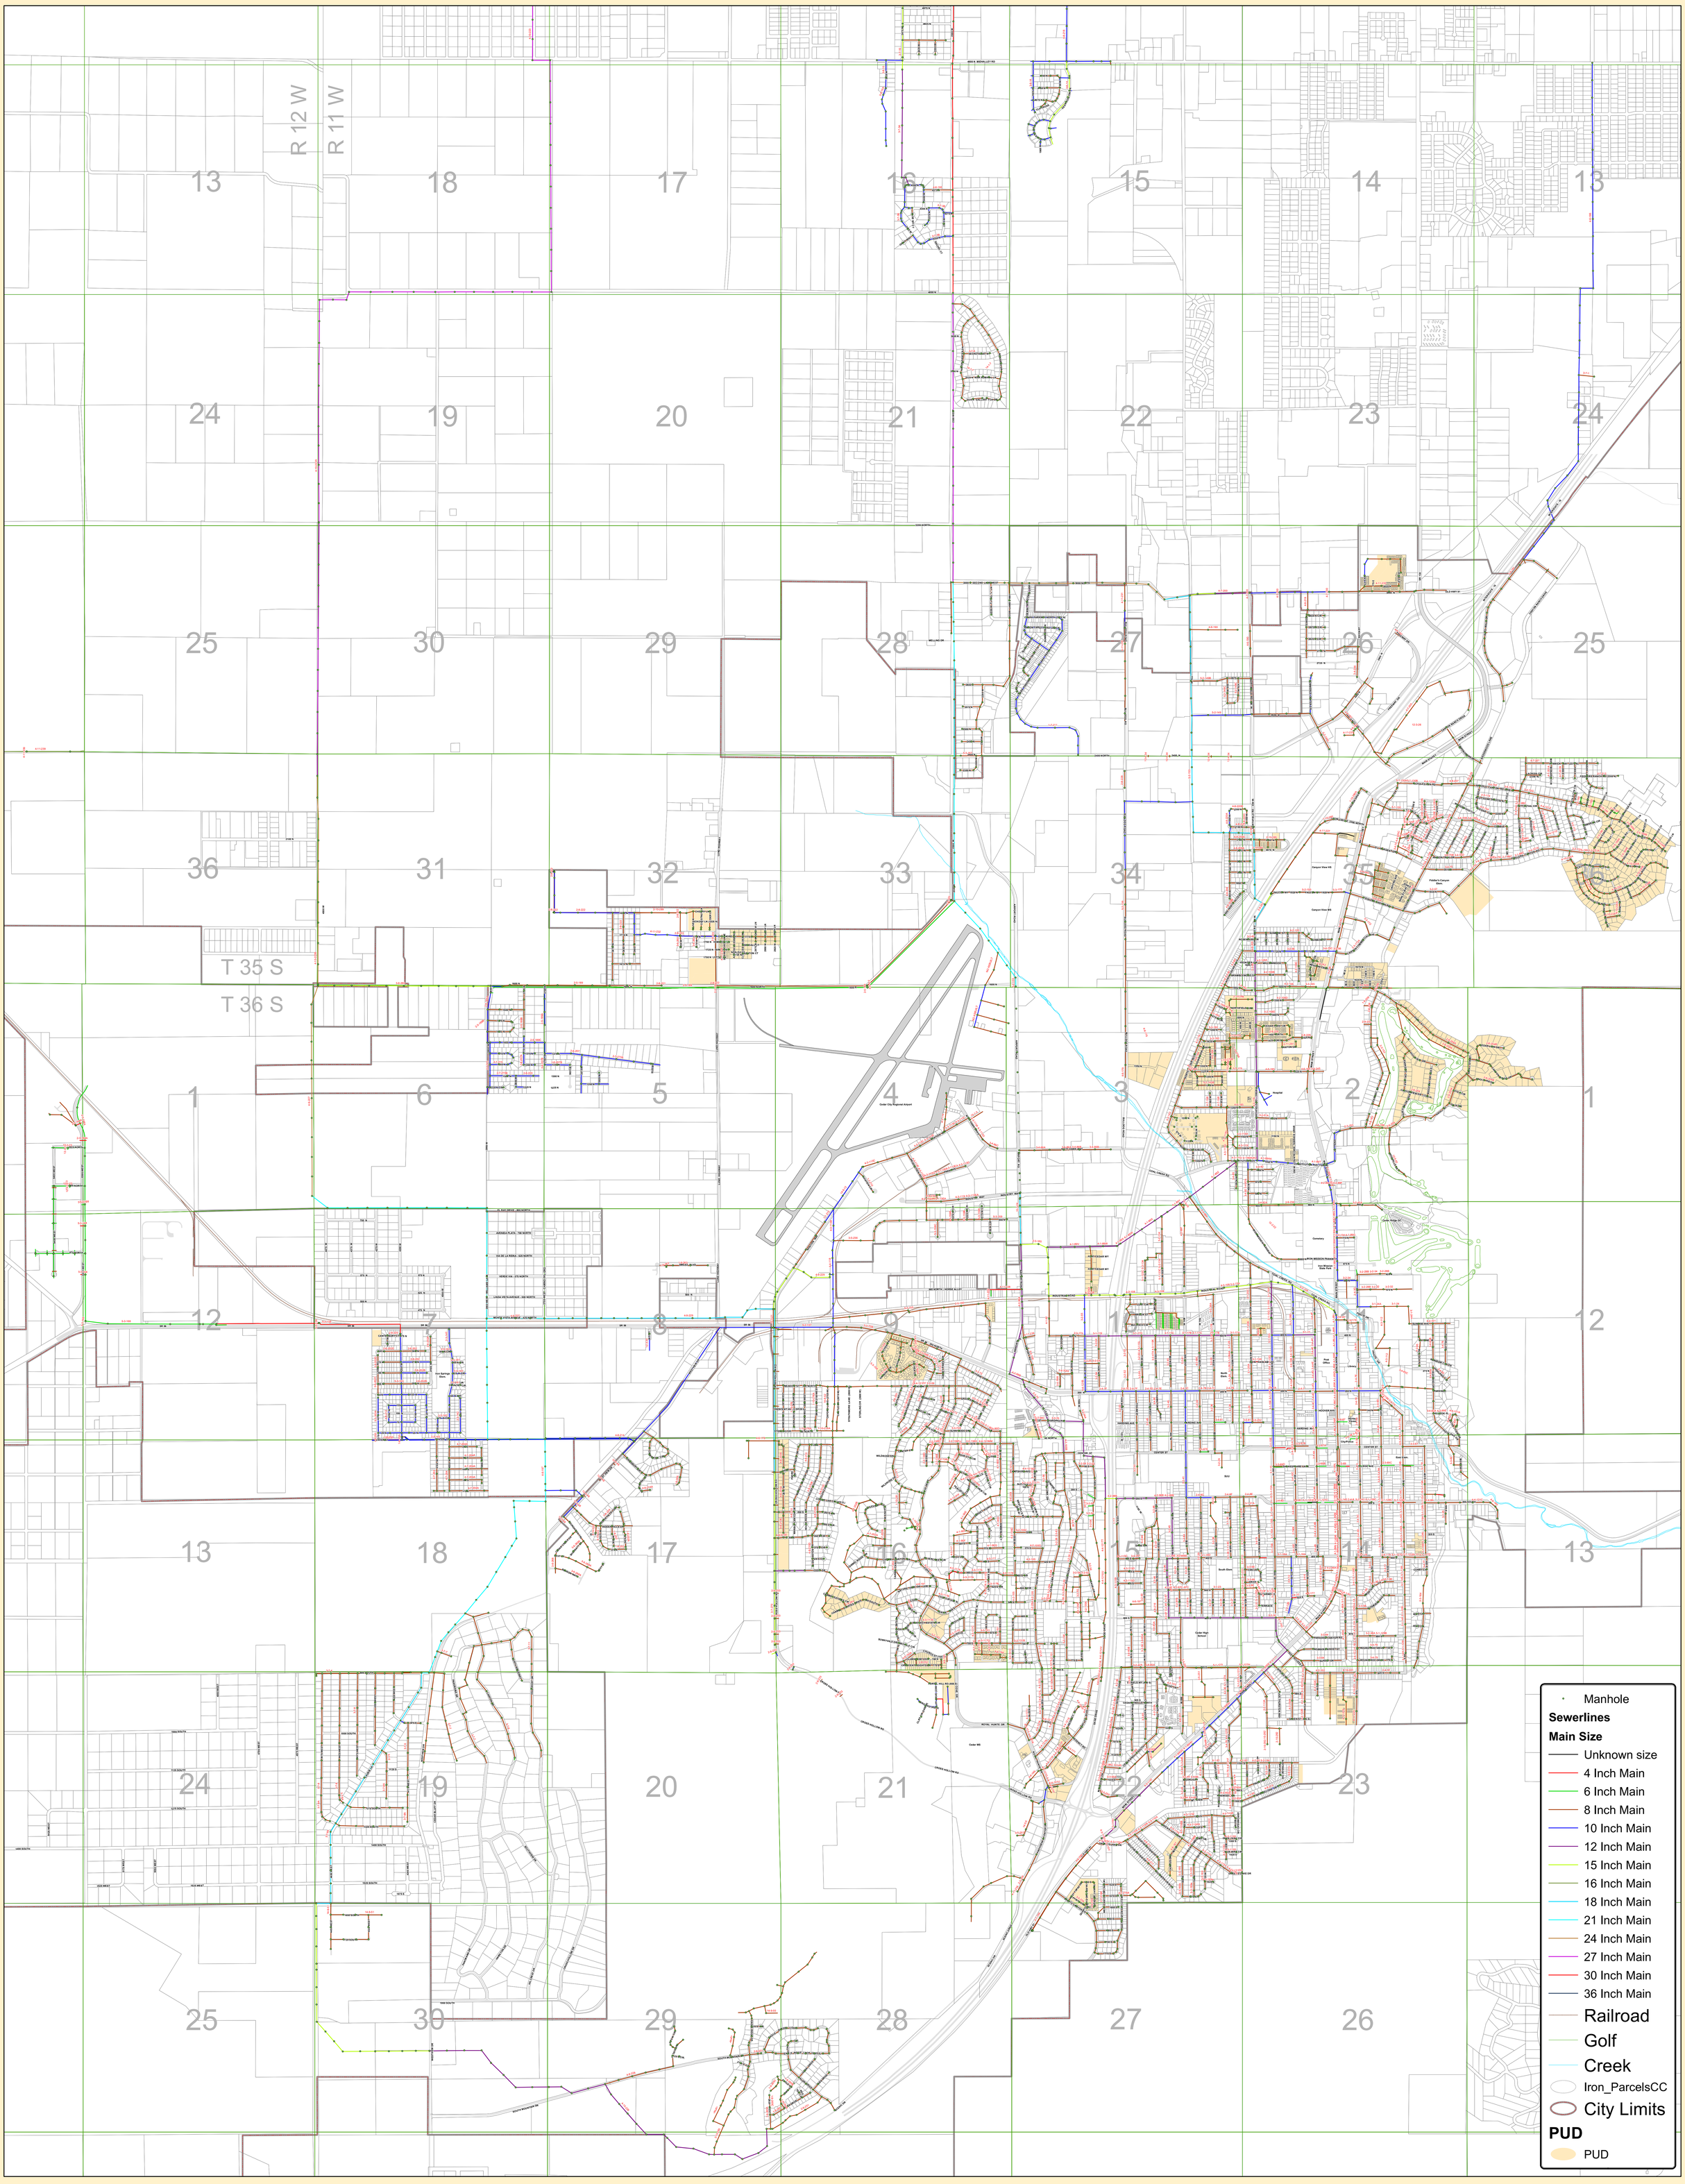

CEDAR CITY CORPORATION

SEWER MAIN ASBUILT MAP

Printed December 1, 2020

N
W E
S

0 1,000 2,000 4,000
FEET